

El Cajon Boulevard Median # M-23 [Cover Page & Summary]

This median strip is located on El Cajon Boulevard between: 38th Street - and - 40th Street / I-15 Intersection

* These documents and associated files are for continued use - ample work space is provided and aerial views supplied.

Notes:

Twelve (12) tree spaces evenly spaced. Three (3) trees missing.

Seven (7) trees with old incandescent decorative lighting installed and not working.

This median is constructed in similar fashion to median number 22 and appears to be wired similarly.

High and low voltage power supplies working and controlled by off site control. Breakers located south side of El Cajon Blvd on sidewalk next to 3753 El Cajon Blvd.

Most low voltage connection boxes at tree bases visually appear serviceable with minimum repairs.

The "pig tails" to ALL trees need upgrading for operation and safety reasons. All exposed wiring is showing signs of weathering and age as older plastics breakdown in sunlight.


Weed Eater damage is extensive - look for better future option that can take this type of normal wear and tear.

Low voltage transformer located in a large above ground stainless steel metal box with ample workspace in good condition, rated at 120V, 1.5kVA, secondary 300W - load circuits undetermined.


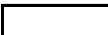
Legend Key for Sub Section Page 3 - "Electrical Infrastructure Diagram for Decorative Lighting"

 Black = Road surface.

 Dark Gray = Concrete structure of the median base and curbs above street level.

 Medium Gray = Foliage and/or open earthen areas within the median strip for planting.

 Light Gray = Tree or a place where a tree should be for lighting infrastructure purposes with a tree designation number.

 or  Blocked White Box = Descriptor of tree lighting infrastructure item.

El Cajon Boulevard Median # M-23 [Top View - Overall Aerial with Intersections and Views]

38th Street

40th Street / I-15 Intersection




El Cajon Boulevard Median # M-23 Electrical Infrastructure Diagram for Decorative Lighting

38th Street

< West [Side View facing North - Planted Areas Only] East >

40th Street / I-15 Intersection

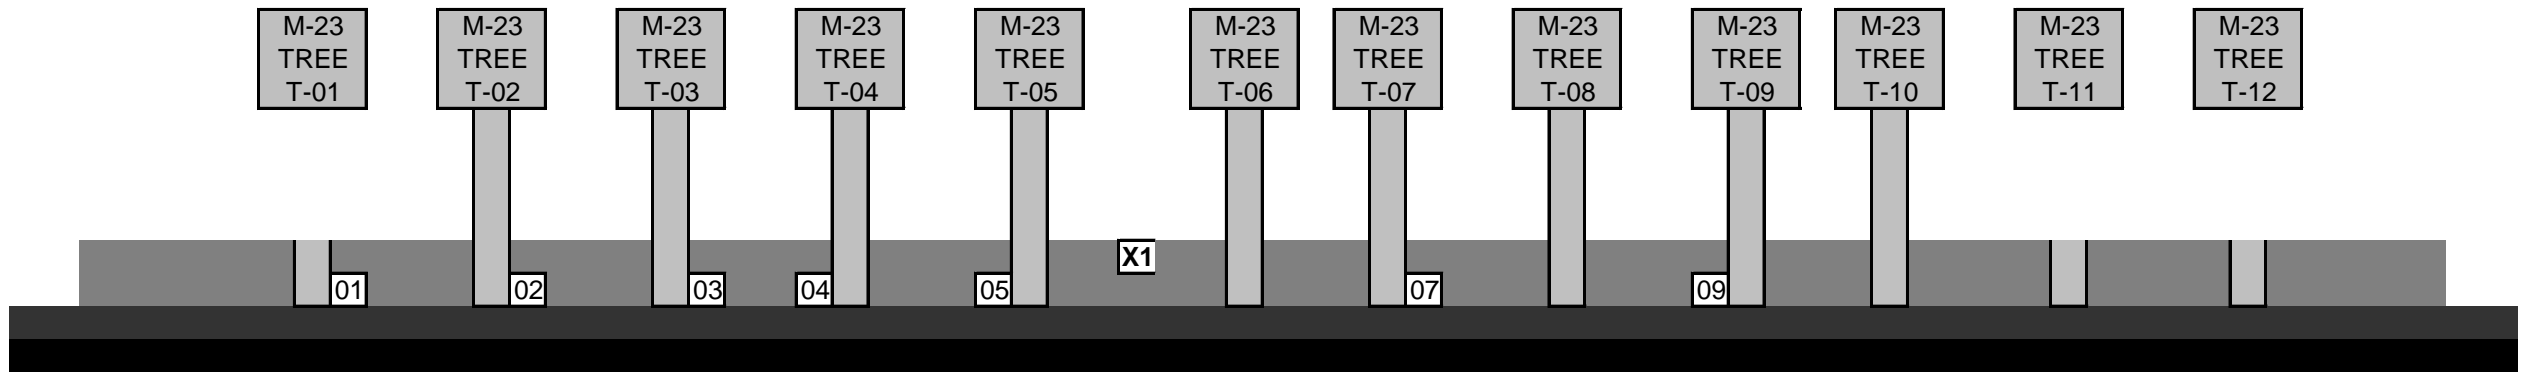

Median Decorative Lighting Electrical Infrastructure Inventory:

Ln	Tree/Item	Description	Item Location	Condition	Lights*	Electrical Reference Value or Type	Feeder	Workable Parameter and Notes	
1	T-01, 01	Connection Box Only	3' NE of T-01	Damaged	None	Low Voltage Connection Box 01	X1 - Sec a	12V unknown at LV box	
2	T-02 & 02	Tree & Connection Box	2' N of T-02	Damaged	NL	Low Voltage Connection Box 02	X1 - Sec a	12V unknown at LV box; cable damaged	
3	T-03 & 03	Tree & Connection Box	3' NE of T-03	Appears serviceable	NL	Low Voltage Connection Box 03	X1 - Sec a	12V unknown at LV box	
4	T-04 & 04	Tree & Connection Box	2' NNW of T-04	Appears serviceable	NL	Low Voltage Connection Box 04	X1 - Sec a	12V unknown at LV box	
5	T-05 & 05	Tree & Connection Box	2.5' NNW of T-05	Appears serviceable	NL	Low Voltage Connection Box 05	X1 - Sec a	12V unknown at LV box	
6	X1	Low Voltage Transformer	15' E of T-05	Damaged		12V AC Transformer at 300W	Fed from electrical box at 3753 El Cajon		
7	T-06	Tree - No Connection Box	Box Missing		NL	Low Voltage Connection Box 06	X1 - Sec a	Cable damaged	
8	T-07 & 07	Tree & Connection Box	2' E of T-07	Appears serviceable	NL	Low Voltage Connection Box 07	X1 - Sec a	12V unknown at LV box	
9	T-08	Tree - No Connection Box	Box Missing		None	Low Voltage Connection Box 08	X1 - Sec a		
10	T-09 & 09	Tree & Connection Box	2.5' NNW of T-09	Appears serviceable	NL	Low Voltage Connection Box 09	X1 - Sec a	12V unknown at LV box	
11	T-10	Tree - No Connection Box	Box Missing		None	Low Voltage Connection Box 10	X1 - Sec a		
12	T-11	Hole	All Missing		None	Low Voltage Connection Box 11	X1 - Sec a		
13	T-12	Hole	All Missing		None	Low Voltage Connection Box 12	X1 - Sec a		
14									
15									
16	Note X1 has 1 transformer in the enclosure (4" clearance not observed) at 120V, 1.5kVA, 300W on secondary; load circuits undetermined.								
17	* NL = strung with lights not lit; YL = strung with working lights; None = not strung with lights								

El Cajon Boulevard Median # M-23 [Top View - Planted Areas Only]

38th Street

40th Street / I-15 Intersection

